

Date: Monday, 7/31/2006 12:51:32 PM  
 User: Kim Johnston

## Process Sheet

Customer	CU-DAR001 Dart Helicopters Services	Drawing Name	: 350/212/130 BASKET LID		
Job Number	28037B	Part Number	: D2512		
Estimate Number	10193	Drawing Number	: D2512 REV D2		
P.O. Number	N/A	Project Number	: N/A		
This Issue	7/31/2006	S.O. No.	: N/A		
Prsht Rev.	NC	Drawing Revision	: D2		
First Issue	N/A	Material	: N/A		
Previous Run	28036B	Due Date	: 8/7/2006 Qty: 1 Um: Each		
Written By	<i>[Signature]</i>				
Checked & Approved By	<i>[Signature]</i>				
Comment	Rev Est:M 03/01/31 Added D2012-117 for D130-701-041 KJ/ RF Est Rev:N 06.04.05 Added level21 EC				

## Additional Product

Job Number:



Seq. #:	Machine Or Operation:	Description :	
1.0	M304TS0750W065	304 SQ Tube.75x.75x.065W	
<b>Comment:</b> Qty.: 45.7594 f(s)/Unit Total : 45.7594 f(s) Pick: 3/4"x3/4" 304/316 SS tube .063" wall Batch: <i>M101561</i> → <i>518,531</i> <i>PCL 06.08.08</i>			
2.0	D31663	Basket Hoop	
<b>Comment:</b> Qty.: 1.0000 Each(s)/Unit Total : 1.0000 Each(s) Pick: Qty Part Number Description Batch 1 D3166-3 Basket Hoop <i>327327</i> <i>PCL 06.08.08</i>			
3.0	D2506	Placard	
<b>Comment:</b> Qty.: 1.0000 Each(s)/Unit Total : 1.0000 Each(s) Pick: Qty Part Number Description Batch 1 D2506 Label Plate <i>326631-2</i> <i>PCL 06.08.08</i>			
4.0	D23271	Spacer Bushing	
<b>Comment:</b> Qty.: 2.0000 Each(s)/Unit Total : 2.0000 Each(s) Pick: Qty Part Number Description Batch 2 D2327-1 Bushing <i>326742</i> <i>PCL 06.08.08</i>			

W/O:		WORK ORDER CHANGES					
DATE	STEP	PROCEDURE CHANGE	By	Date	Qty	Approval Mfg / Design Mgr	Approval QC Inspector

NCR:		WORK ORDER NON-CONFORMANCE (NCR)						
DATE	STEP	Description of NC Section A	Corrective Action Section B			Verification Section C	Approval Design Mgr	Approval QC Inspector
			Initial Design Mgr	Action Description Design Mgr	Sign & Date			

Part No: \_\_\_\_\_ PAR #: \_\_\_\_\_ Fault Category: \_\_\_\_\_ NCR: Yes No DQA: \_\_\_\_\_ Date: \_\_\_\_\_

NOTE: Date & initial all entries QA: N/C Closed: \_\_\_\_\_ Date: \_\_\_\_\_

Date: Monday, 7/31/2006 12:51:33 PM  
User: Kim Johnston

## Process Sheet

Customer: CU-DAR001 Dart Helicopters Services

Drawing Name: 350/212/130 BASKET LID

Job Number: 28037B

Part Number: D2512

Job Number:



Seq. #: Machine Or Operation:

Description :

5.0 D22321 Hinge



Comment: Qty.: 2.0000 Each(s)/Unit Total : 2.0000 Each(s)

Pick:

Qty	Part Number	Description	Batch
2	D2232-1	Hinge plate	<i>B25238</i>

*CPL 06-08-08*

6.0 D2581 Mounting Bracket



Comment: Qty.: 2.0000 Each(s)/Unit Total : 2.0000 Each(s)

Pick:

Qty	Part Number	Description	Batch
2	D2581	Mounting Bracket	<i>B27524</i>

*CPL 06-08-08*

7.0 M304EX07516F Expanded Metal Flat Stai



Comment: Qty.: 18.0000 sf(s)/Unit Total : 18.0000 sf(s)

Pick:

Qty	Part Number	Description	Batch
18 sf	M304EX0.75-16F	Expanded Metal	<i>M101707</i>

*CPL 06-08-09*

8.0 LARGE FAB 1 LARGE FABRICATION RESOURCE 1



Comment: LARGE FABRICATION RESOURCE 1

1-Cut 3/4" x 3/4" square tubing as per Dwg D2512

2-Cut (4) D2236 From D3166-3

3-Drill holes in D2512-1 as per Dwg D2512 using Drill Jig DT8305

5-Weld as per Dwg D2512 using Welding Table and corner Jig Deburr as required

*CPL 06-08-15*

9.0 QC9/6 DDIMENSIONAL & WELDING INSPECTION



Comment: DDIMENSIONAL & WELDING INSPECTION

*PD 06-08-16 1D*

W/O:		WORK ORDER CHANGES					
DATE	STEP	PROCEDURE CHANGE	By	Date	Qty	Approval Mfg / Design Mgr	Approval QC Inspector

NCR:		WORK ORDER NON-CONFORMANCE (NCR)						
DATE	STEP	Description of NC Section A	Corrective Action Section B			Verification Section C	Approval Design Mgr	Approval QC Inspector
			Initial Design Mgr	Action Description Design Mgr	Sign & Date			

Part No: \_\_\_\_\_

PAR #: \_\_\_\_\_

Fault Category: \_\_\_\_\_

NCR: Yes

 NoDQA: Date: 06/08/27

NOTE: Date &amp; initial all entries

QA: N/C Closed: \_\_\_\_\_

Date: \_\_\_\_\_

Date: Monday, 7/31/2006 12:51:33 PM  
User: Kim Johnston

## Process Sheet

Customer: CU-DAR001 Dart Helicopters Services

Drawing Name: 350/212/130 BASKET LID

Job Number: 28037B

Part Number: D2512

Job Number:



Seq. #:

Machine Or Operation:

Description :

10.0

POWDER COATING

POWDER COATING



Comment: POWDER COATING

Powder Coat White Gloss (Ref: 4.3.5.1) as per QSI 005 4.3

DC 06/08/23 ①

11.0

HAND FINISHING1

HAND FINISHING RESOURCE #1



Comment: HAND FINISHING RESOURCE #1

Wing Walk and Spray Paint black as per Dwg D2512 and QSI 005 4.4

Batch: MP1266 RC 06/08/23 ①

12.0

QC3

INSPECT POWDER COAT/CHEMICAL CONVERSION



Comment: INSPECT POWDER COAT/CHEMICAL CONVERSION

MF. 06/08/24

13.0

PACKAGING 1

PACKAGING RESOURCE #1



Comment: PACKAGING RESOURCE #1

Identify and Stock

Location: G.A.

MF. 06/08/24

14.0

DC

DOCUMENT CONTROL



Comment: DOCUMENT CONTROL

Inspection Level 21

06.08.25

Job Completion



06.08.25

W/O:		WORK ORDER CHANGES							
DATE	STEP	PROCEDURE CHANGE			By	Date	Qty	Approval Mfg / Design Mgr	Approval QC Inspector

NCR:		WORK ORDER NON-CONFORMANCE (NCR)								
DATE	STEP	Description of NC Section A	Corrective Action Section B			Verification Section C	Approval Design Mgr	Approval QC Inspector		
			Initial Design Mgr	Action Description Design Mgr	Sign & Date					

Part No: \_\_\_\_\_ PAR #: \_\_\_\_\_ Fault Category: \_\_\_\_\_ NCR: Yes No DQA: \_\_\_\_\_ Date: \_\_\_\_\_

NOTE: Date & initial all entries

QA: N/C Closed: \_\_\_\_\_ Date: \_\_\_\_\_




DESIGN BW	DRAWN BY <i>CP</i>	DART AEROSPACE LTD HAWKESBURY, ONTARIO, CANADA	
CHECKED <i>✓</i>	APPROVED <i>✓</i>	DRAWING NO. D2512	REV. D SHEET 1 OF 4
DATE 01.04.19		TITLE BASKET LID ASSEMBLY (350/212) NTS	

**RELEASED**  
01.04.27 *✓*

A	95.11.21	NEW ISSUE
B	96.05.24	ADDED LATCH CHANNEL & LABEL PLATE
C	99.07.06	REMOVE DOUBLE SKIN SECTION, ADDED MEMBERS, INCORP. DEO 9074
D	01.04.19	CHANGE HINGE
D1	<del>CP</del> 03.01.20	ADD D2012-117 FOR D130-701-041
D2	<del>CP</del> 04.09.20	TACK WELD BNT-SKID AREA

PARTS LIST FOR D2512 BASKET LID ASSEMBLY

PART NO	QUANTITY	LENGTH A	LENGTH B	DESCRIPTION
D2512-1	2	—	25.50	RIB
D2512-3	2	—	95.30	RIB
D2512-5	6	30.84	—	RIB
D2512-7	3	30.63	—	RIB
D2232-1	2	N/A	N/A	HINGE PLATE
D2236	4	N/A	N/A	RIB
D2327-1	2	N/A	N/A	BUSHING
D2506	1	N/A	N/A	LABEL PLATE
D2581	2	N/A	N/A	MOUNTING BRKT

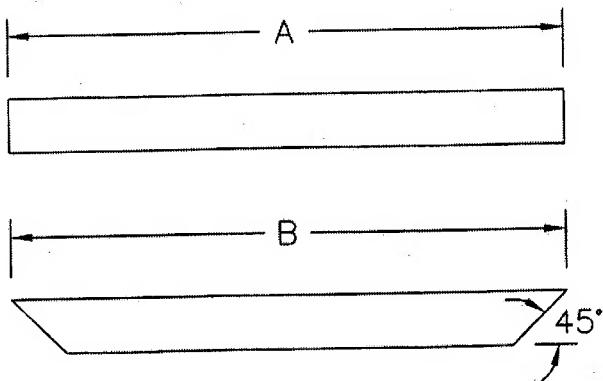

SHOP COPY  
RETURN TO  
ENGINEERING  
UNCONTROLLED COPY  
SUBJECT TO AMENDMENT  
WITHOUT NOTICE  
WORK ORDER  
NO. *280373*

D2512-1/-3/-5/-7

CUT LENGTH/SHAPE PER DIAGRAM AND PARTS LIST

 
MATERIAL: AISI 304/316 SS, 3/4 X 3/4 X 0.060 WALL SQUARE TUBING


TOLERANCES ARE PER DART QSI 018 UNLESS OTHERWISE NOTED

ALL DIMENSIONS ARE IN INCHES

Copyright © 1995 by DART AEROSPACE LTD

THIS DOCUMENT IS PRIVATE AND CONFIDENTIAL AND IS SUPPLIED ON THE EXPRESS CONDITION THAT IT IS NOT TO BE USED FOR ANY PURPOSE OR COPIED OR COMMUNICATED TO ANY OTHER PERSON WITHOUT WRITTEN PERMISSION FROM DART AEROSPACE LTD.



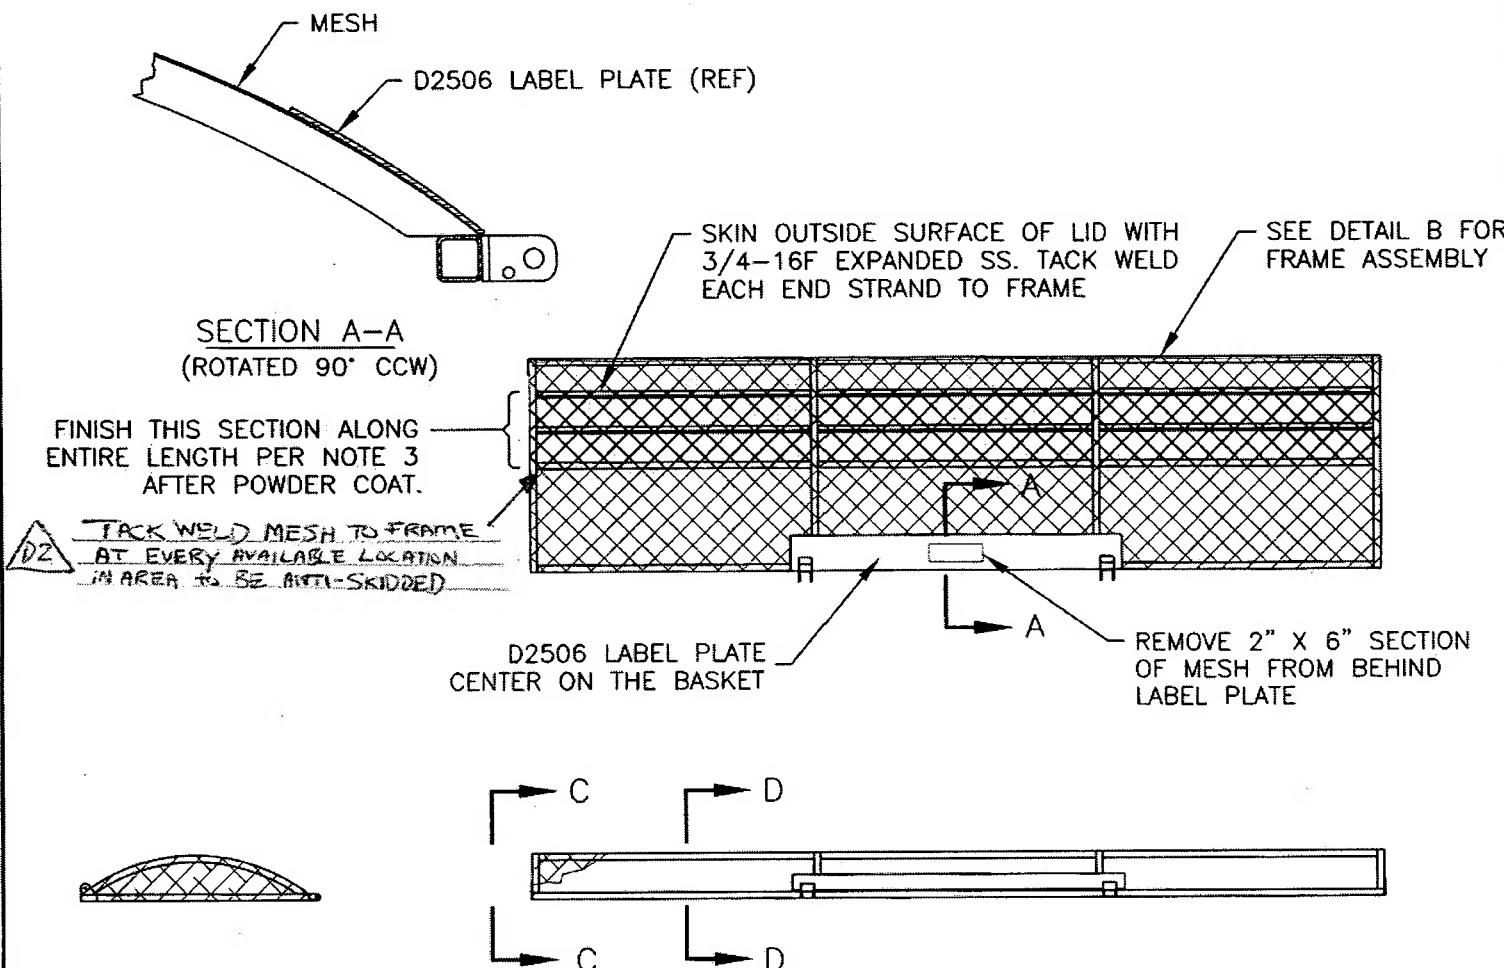

D2512 BASKET LID ASSEMBLY

- 1) MESH MATERIAL: 3/4-16F EXPANDED SS
- 2) FINISH: POWDER COAT ENTIRE ASSEMBLY WHITE (4.3.5.2) PER DART QSI 005 4.3
- 3) SPRAY PAINT BLACK INSIDE SURFACE  
APPLY BLACK ANTI-SKID TO OUTSIDE SURFACE PER DART QSI 005 4.4
- 4) TOLERANCES ARE PER DART QSI 018 UNLESS OTHERWISE NOTED
- 5) ALL DIMENSIONS ARE IN INCHES

RELEASED  
IN COMPLIANCE  
WITH NOTICE  
NO. 28037-B  
WORK ORDER  
COPY  
ENGINEERING  
RETURN TO  
SHOP COPY

DESIGN BW	DRAWN BY JF	DART AEROSPACE LTD HAWKESBURY, ONTARIO, CANADA
CHECKED H	APPROVED H	DRAWING NO. D2512
DATE 01.04.19	TITLE BASKET LID ASSEMBLY (350/212)	REV. D SHEET 2 OF 4 SCALE 1:20




© DART  
COPY  
CENTRE



**DART**GACOPY  
SHEET 1 OF 4

DESIGN	DRAWN BY	DART AEROSPACE LTD
BW	JP	HAWKESBURY, ONTARIO, CANADA
CHECKED	APPROVED	DRAWING NO.
		D2512
DATE		SHEET 3 OF 4
01.04.19		SCALE
		1:20
		TITLE
		BASKET LID ASSEMBLY (350/212)

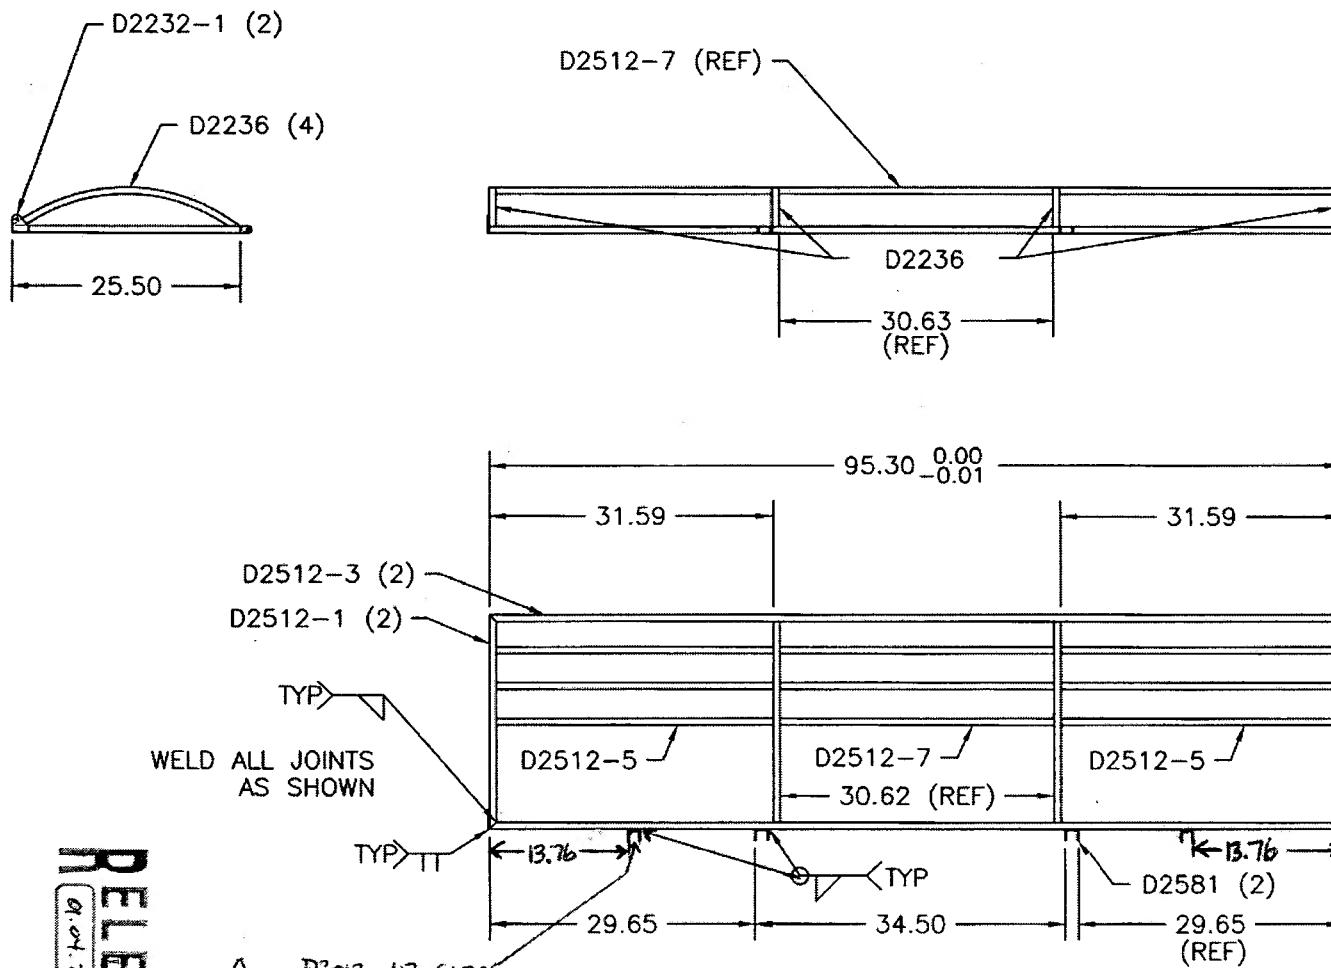**DETAIL B**

FRAMEWORK SHOWN FOR CLARITY  
TOLERANCES ARE PER DART QSI 018 UNLESS OTHERWISE NOTED  
ALL DIMENSIONS ARE IN INCHES


**RELEASED**  
04.2019  
ENGINEERING  
COPY  
RETURN TO  
AMENDMENT  
WITHOUT NOTICE  
WORK ORDER  
NO. 28037B

THIS DOCUMENT IS PRIVATE AND CONFIDENTIAL AND IS SUPPLIED ON THE EXPRESS CONDITION THAT IT IS NOT TO BE USED FOR ANY PURPOSE OR COPIED OR COMMUNICATED TO ANY OTHER PERSON WITHOUT WRITTEN PERMISSION FROM DART AEROSPACE LTD.



Copyright © 1995 by DART AEROSPACE LTD



DESIGN BW	DRAWN BY <i>Up</i>	DART AEROSPACE LTD HAWKESBURY, ONTARIO, CANADA	
CHECKED <i>[initials]</i>	APPROVED <i>[initials]</i>	DRAWING NO. D2512	REV. D SHEET 4 OF 4
DATE 01.04.19	TITLE BASKET LID ASSEMBLY (350/212)	SCALE 1:8	

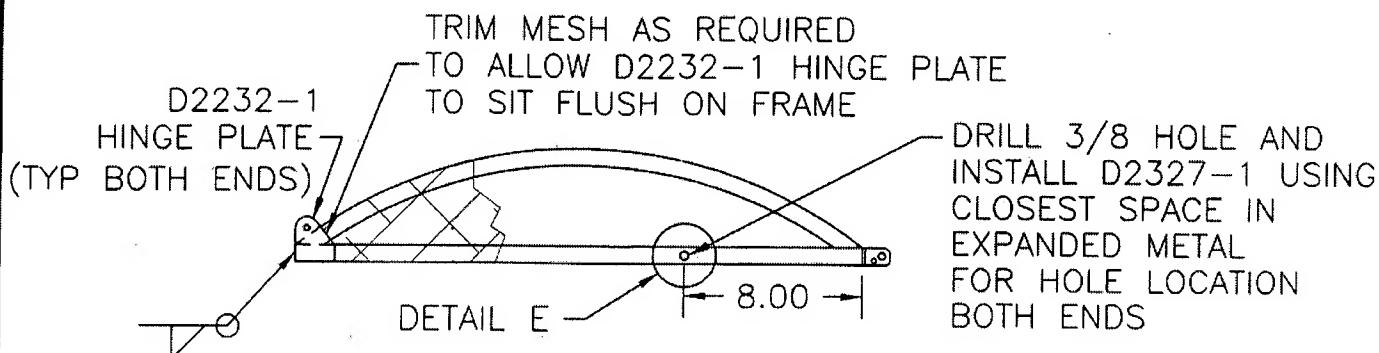

SECTION C-C SIMILIAR BOTH END RIBS

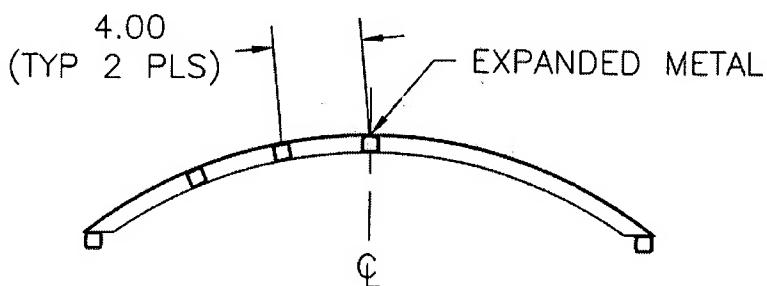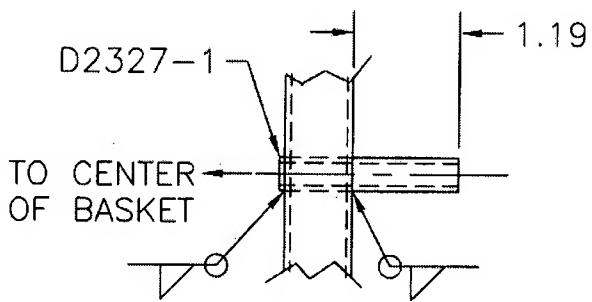

SECTION D-D SAME BOTH CENTER RIBS

SHOP COPY  
RETURN TO  
ENGINEERING

UNCONTROLLED COPY  
SUBJECT TO AMENDMENT  
01.04.2014  
RELEASED  
WORK ORDER  
NO. 28037B